




proposed front elevation

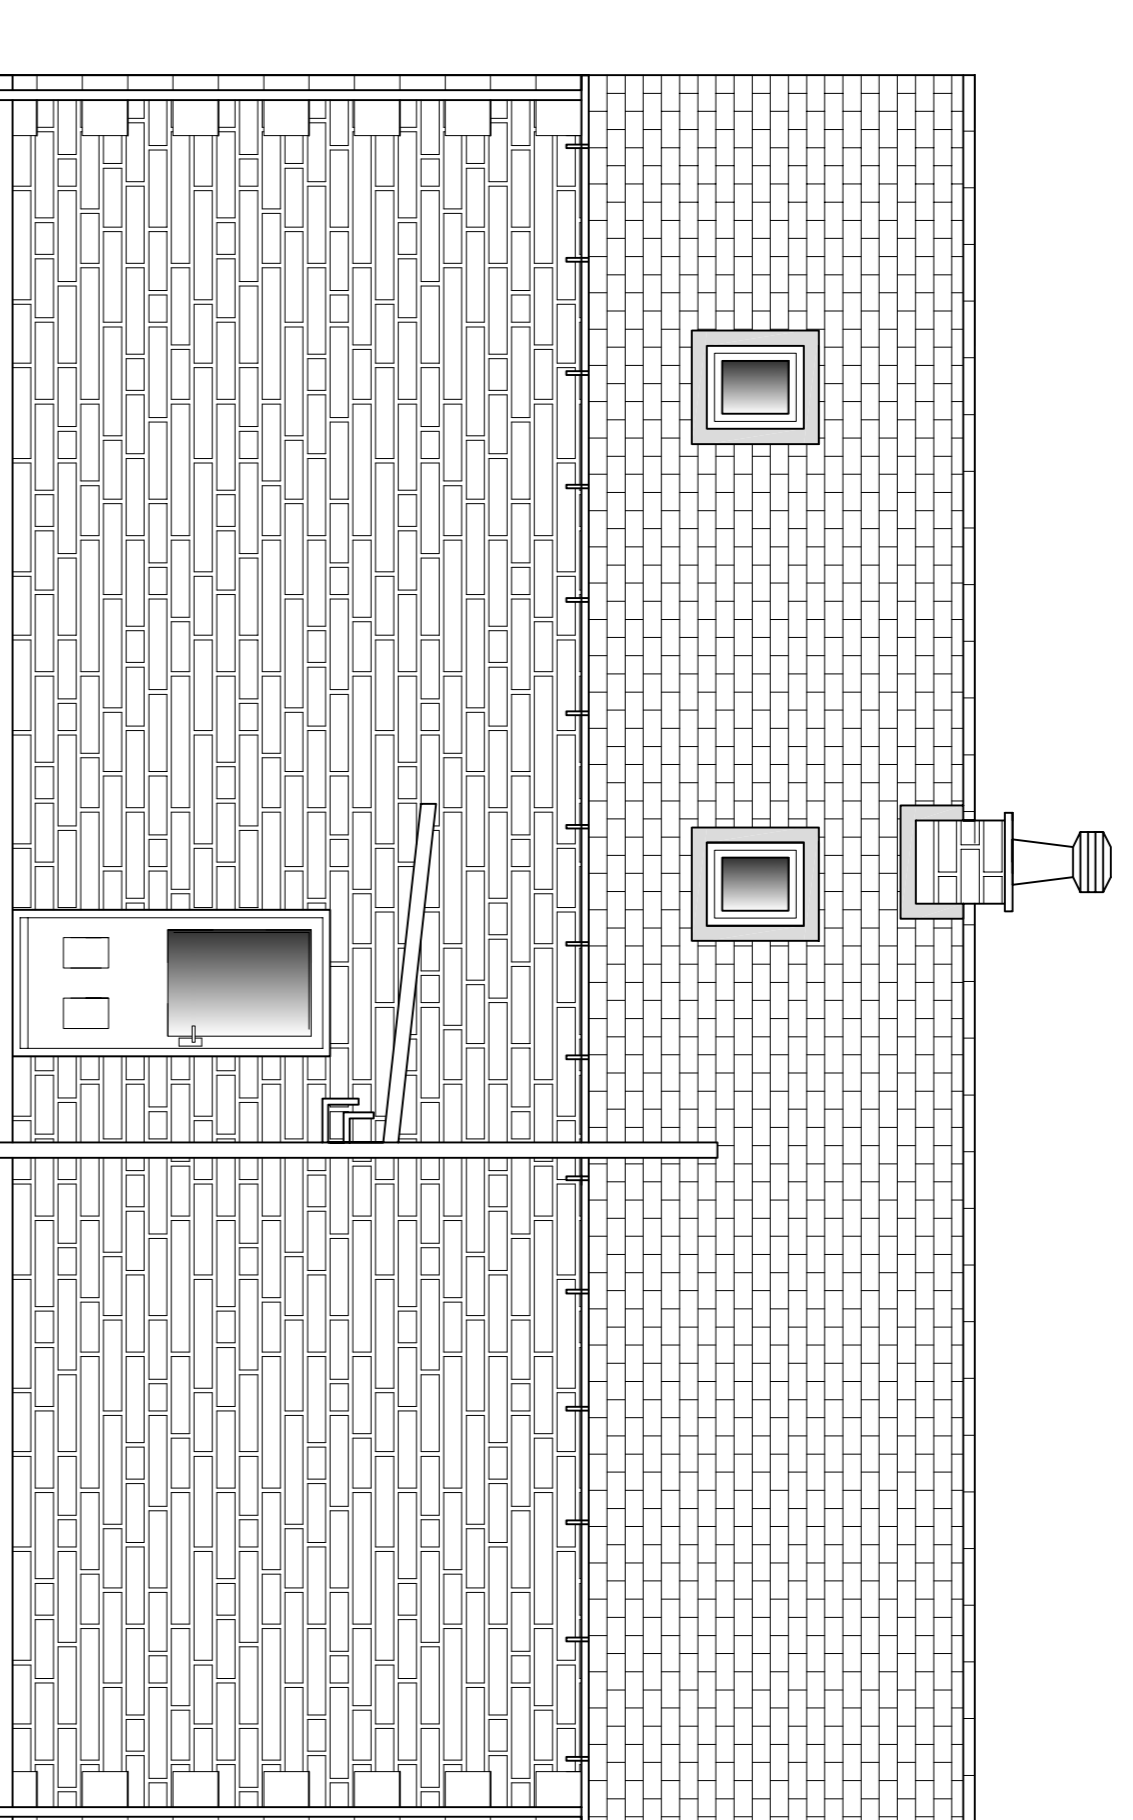

proposed side elevation

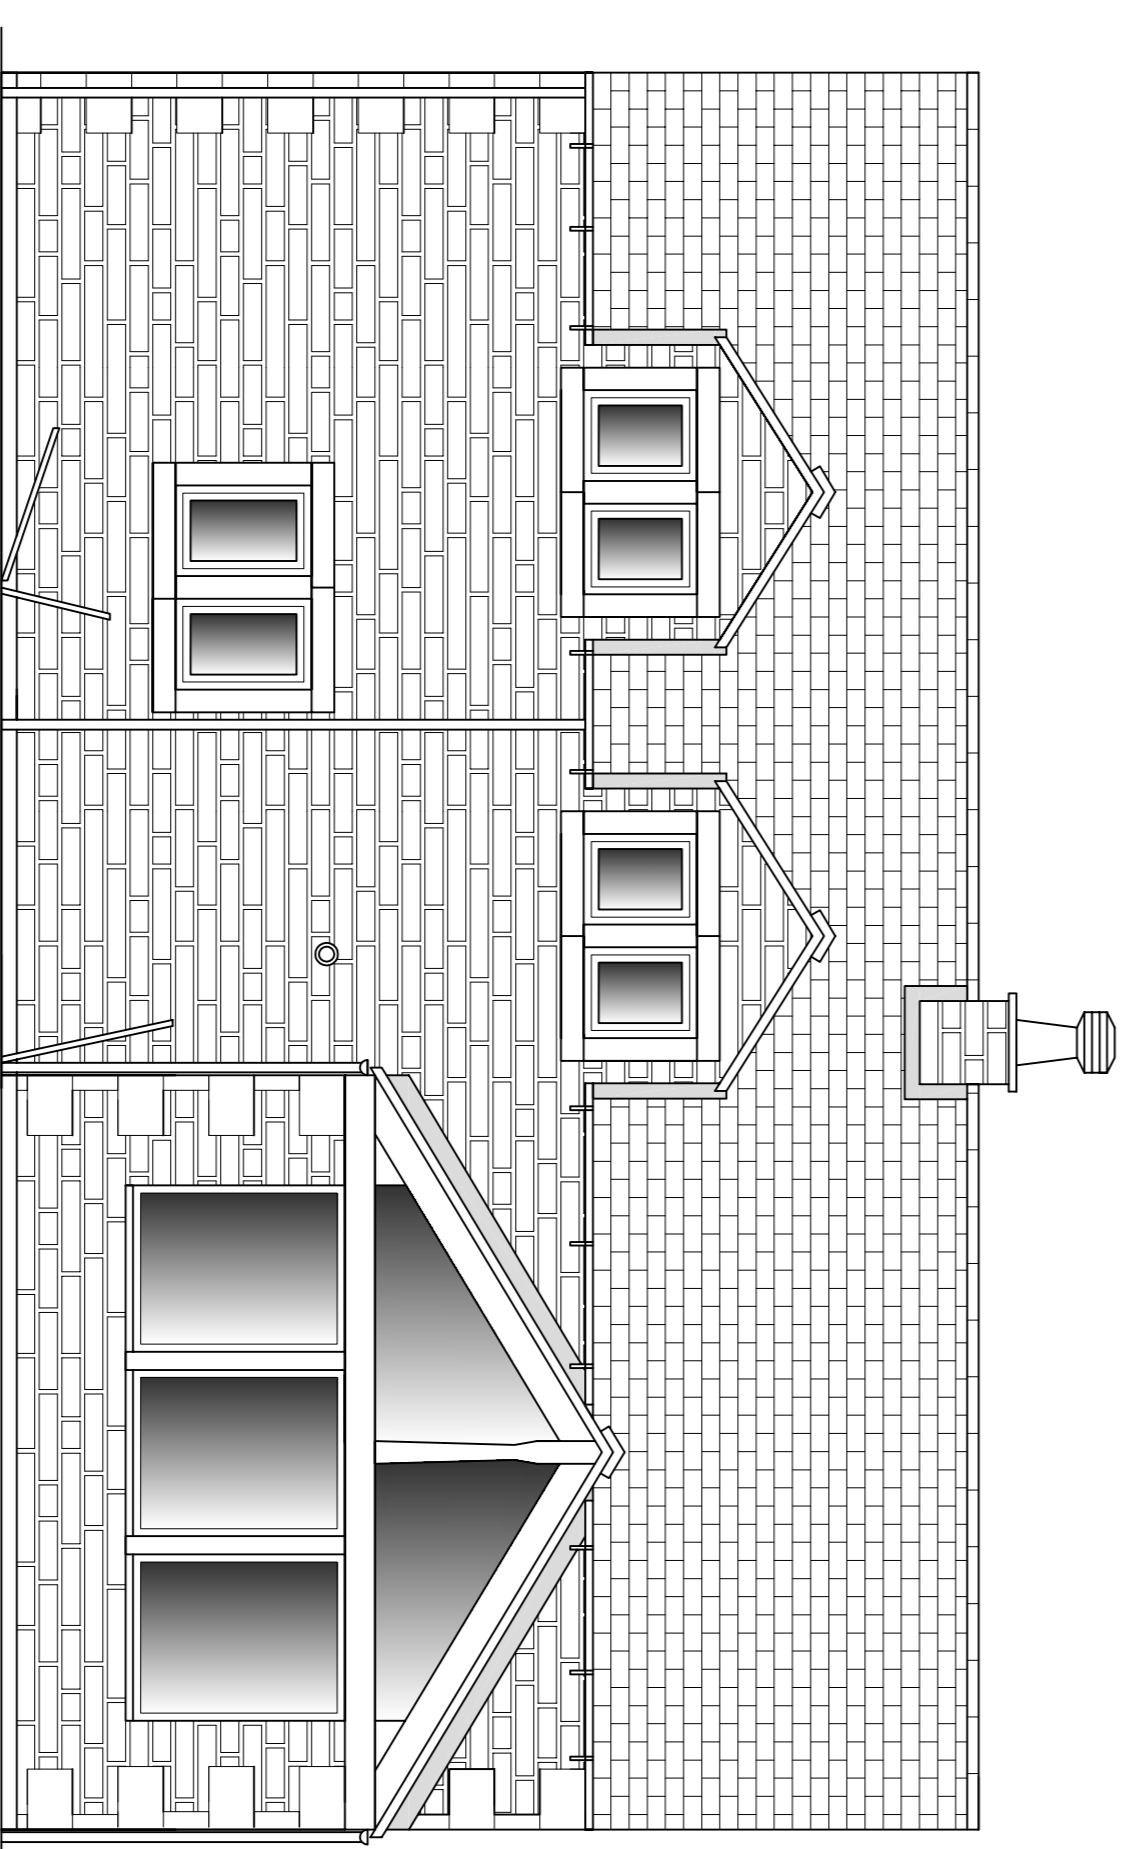

proposed side elevation

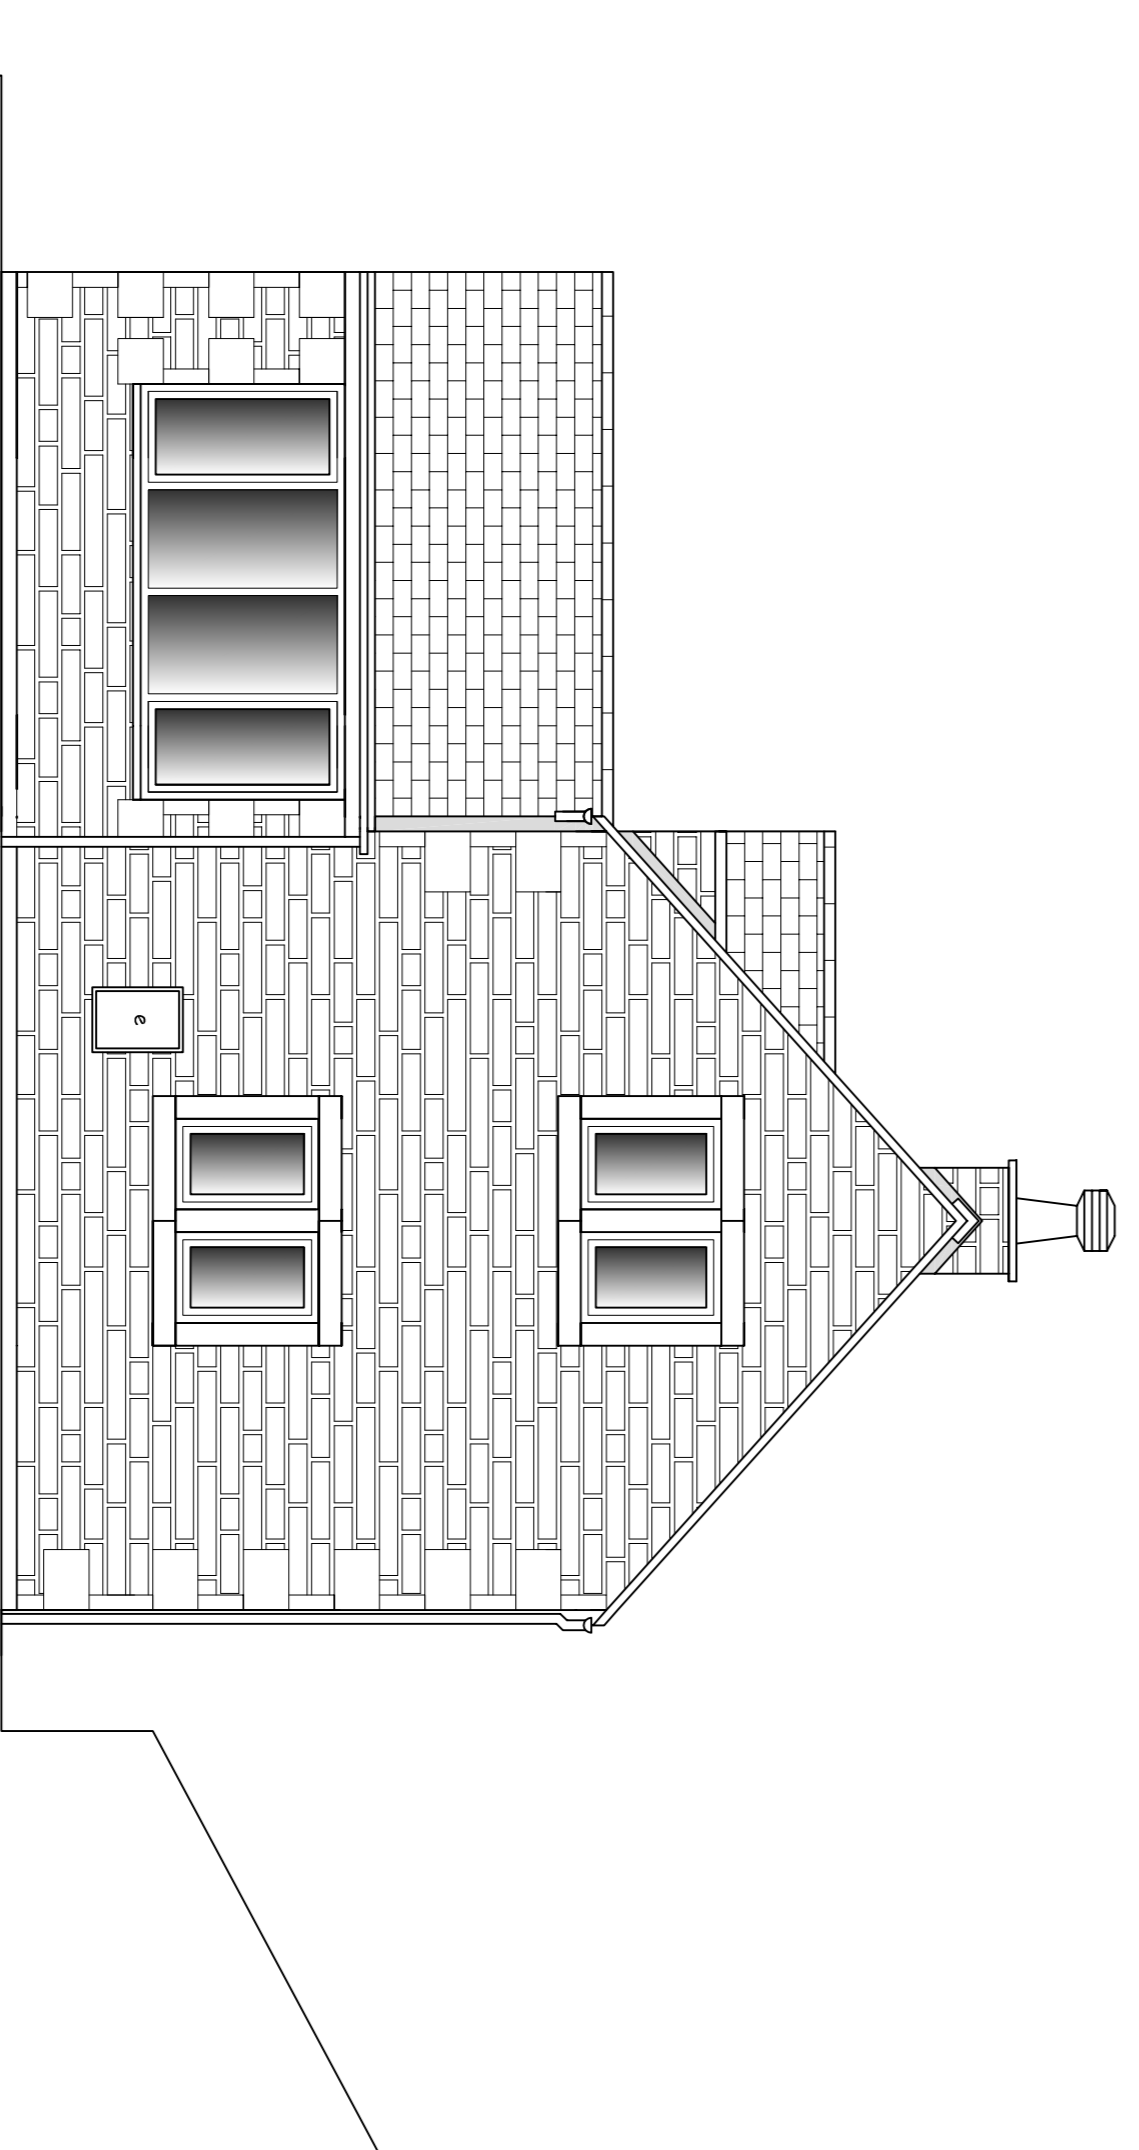

proposed rear elevation

Revisions	Date	A
Shine Stone R.S. Char. M.B.S. Reg. Member Reg. No. 898 6 Binky Close, Clowes, Chesterfield, Derbyshire, S43 5SL tel: 01246 812519 fax: 01246 812519 mobile: 07828 816308 email: shine@tesella.co.uk web: www.tesella.co.uk		
Proposal	Retention of renovation to abandoned dwelling	
Address	Rough Close Farm, Highreidish, Ashover	
Client	Dr. T. Parkin	
Plan	As built elevations	
Scales	1:50	
Date	March, 2010	